
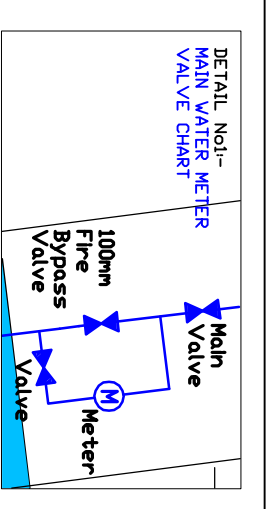


St John's Centre

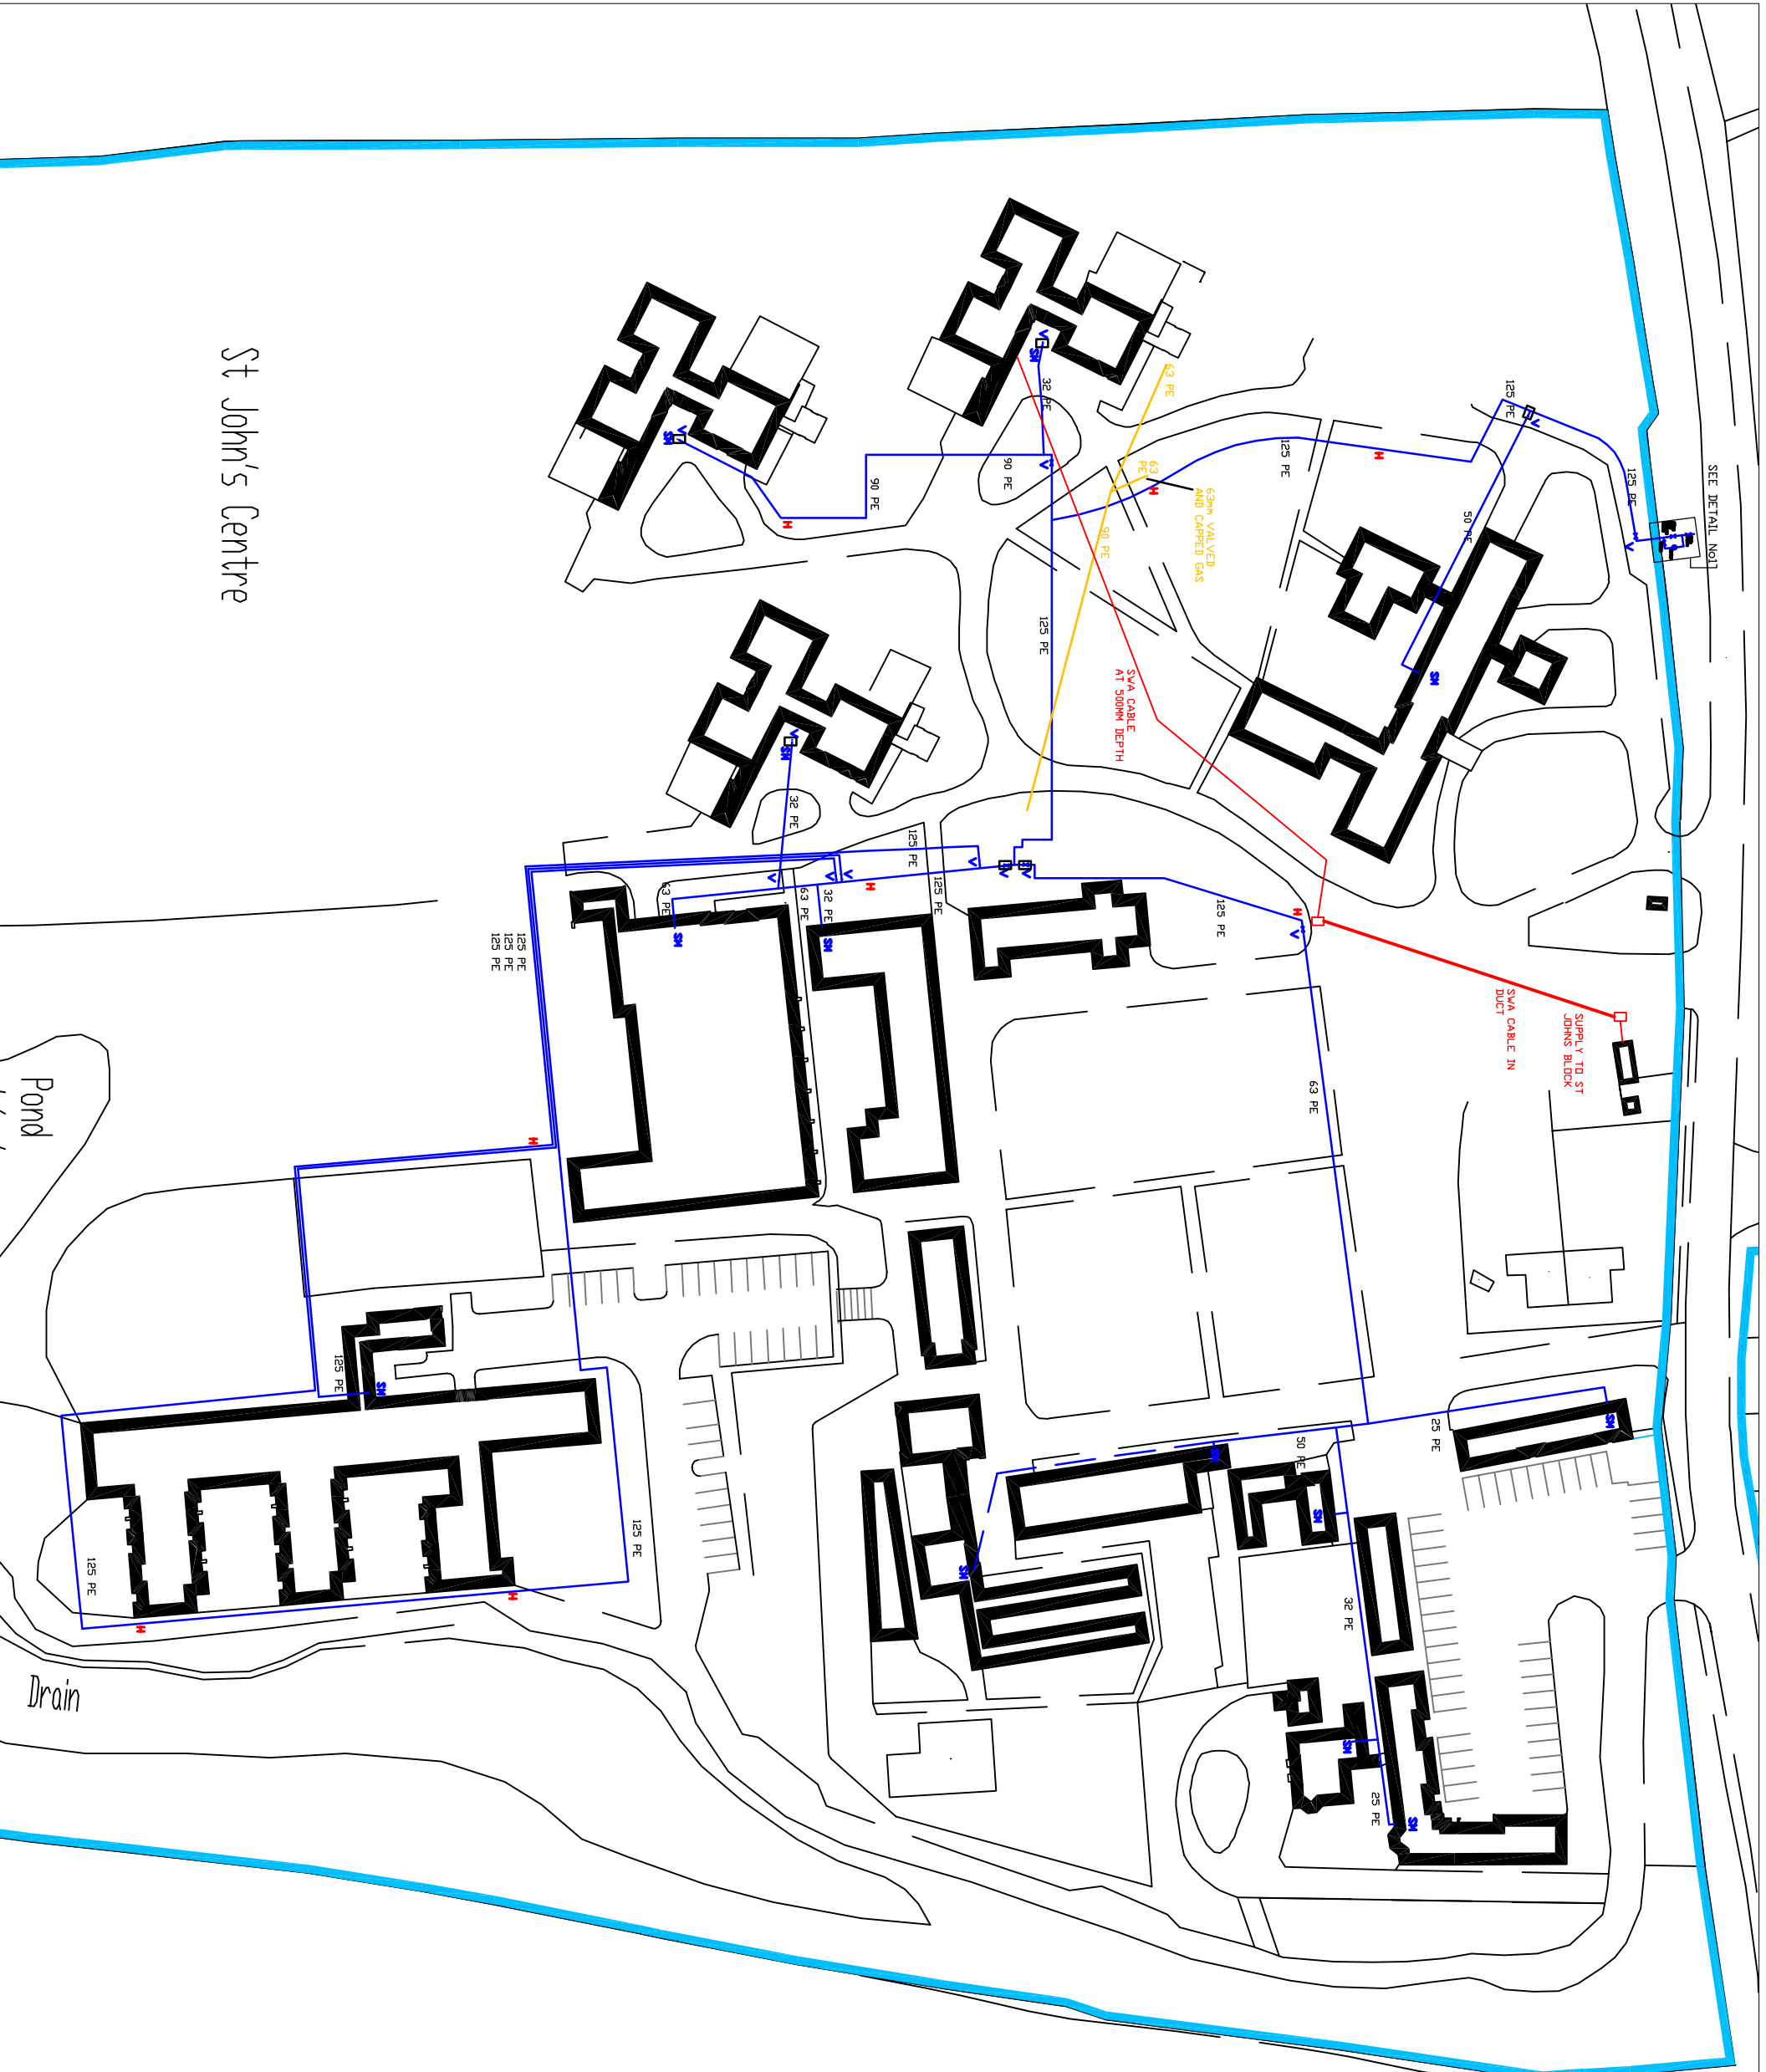

- KEY:-
- H - FIRE HYDRANTS
 - V - EXTERNAL ISOLATION VALVE
 - SM - SUB METER
 - - - - - EXISTING UNKNOWN ROUTE
 - M - MAIN WATER METER

SITE:-	TIFFIELD ST JOHN CENTRE
PROJECT:-	EXTERNAL P/E WATER SERVICES
DATE:-	10/03/04 DRAWING NO:- S0119M
SCALE:-	NOT TO SCALE TITLE:- AS INSTALLED
BROWN PROPERTY REPAIRS (NORTHAMPTON) LTD 2 HERVEY STREET NORTHAMPTON NN1 3QU TEL 01604 231570 EMAIL admin@brownpropertyrepairs.co.uk	